

WALL BRACING SCHEDULE AND NOTES

- P(x) PLYWOOD BRACING (6.4 kN/m RATING) FIXED IN ACCORDANCE WITH AS1684.2 TABLE 8.18(h).
- (x) DENOTES LENGTH OF PLY BRACING. REFER DRAWING ST-08.
- DOUBLE BRACED WALLS TO HAVE M16 TIE DOWN RODS.
- WALLS SHORTER THAN 900mm TO HAVE M12 TIE DOWN RODS EACH END.
- CEILING DIAPHRAGM ACTION IS REQUIRED TO DISTRIBUTE LOADS TO BRACING WALLS.


TRUSS NOTES

1. TRUSS LAYOUT SHOWN IS INDICATIVE ONLY. TRUSS LAYOUT AND DESIGN BY TRUSS MANUFACTURER.
2. ALL TRUSSES ARE TO BE PRE-FABRICATED TIMBER ROOF TRUSSES DESIGNED AND CERTIFIED BY A CERTIFIED ENGINEER ENGAGED BY THE CONTRACTOR.
3. ALL TRUSS TO TRUSS CONNECTIONS ARE TO BE DESIGNED BY THE TRUSS MANUFACTURER WITH DRAWING ST-01 & 11 SHOWING THE MINIMUM REQUIREMENTS.


FRAMING LEGEND

- C1 75 x 4 SHS COLUMN.
- B1 200 x 100 x 4 RHS BEAM.
- B2 125 x 75 x 4 RHS BEAM.
- J1 125 x 50 UNS HWD F14 JOIST AT 450 CTS.
- PP1 125 x 50 UNS HWD F14 POLE PLATE.
- PP2 90 x 6 EA POLE PLATE.
- R1 Z20024 RAFTER AT 900 CTS MAX. LAP 900
2 ROWS OF BRIDGING.
- R2 Z15015 RAFTER AT 900 CTS MAX. 2 ROWS BRIDGING.
or 225 x 50 F14 UNS HWD.
- R3 100 x 50 F14 UNS HWD RAFTER AT 900 CTS MAX.
- R4 Z15019 RAFTER AT 900 CTS MAX. 1 ROW BRIDGING
or 200 x 45 LVL.
- STR1 150 PFC STAIR STRINGER.
- XB1 30 x 1.2mm GL (GR500) DIAGONAL STRAP BRACING.
1-12g TEK SCREW EACH BATTEN. LOOP OVER ENDS
WITH 4-12g TEK SCREWS TO RAFTER/TRUSS.
- (o) MEMBER OVER.
- (u) MEMBER UNDER.
- (c) MEMBER CONTINUOUS.


ROOF FRAMING PLAN
SCALE 1:100

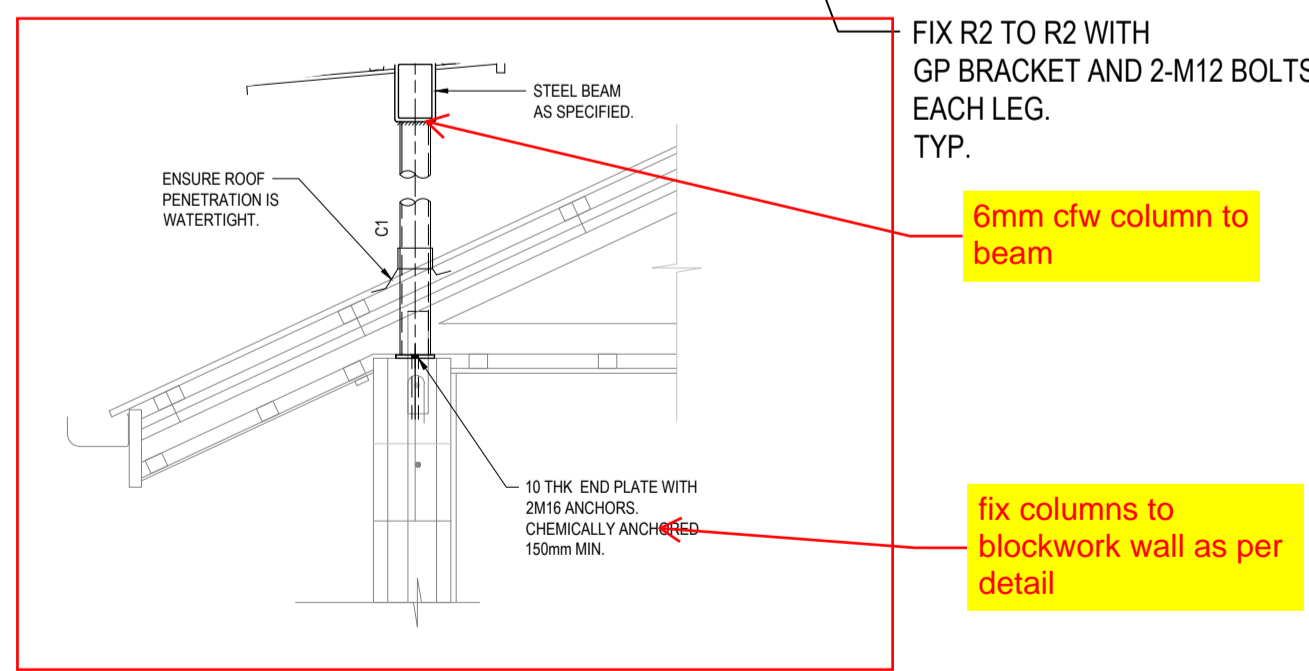

Column to blockwork wall

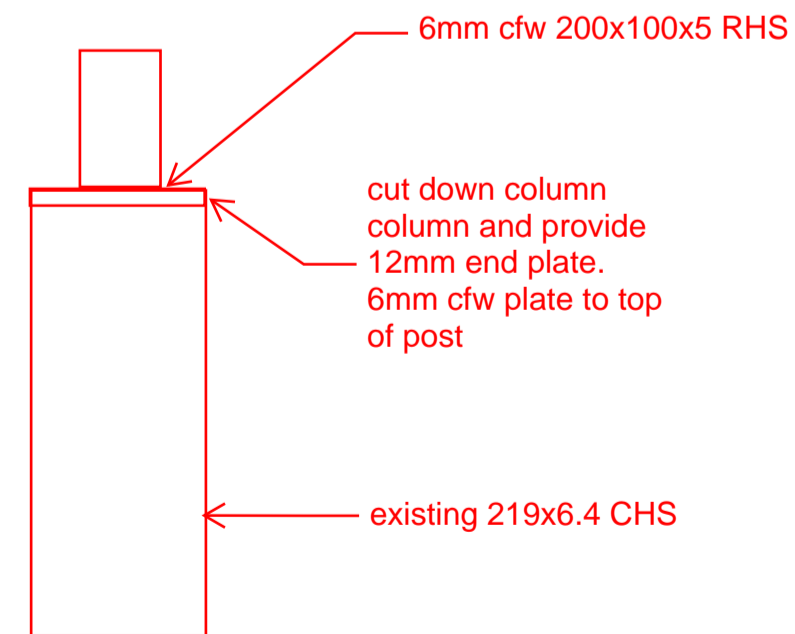

200x100 RHS to Column

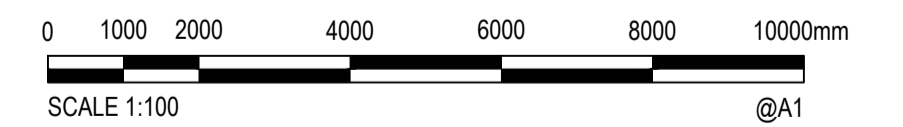

Rev.	Date	Description	Des.	Verif.	Appd.
1	24.1.25	DESIGN REVIEW ISSUE		TK	ML

CERTIFICATION

COPYRIGHT ©

These designs and drawings are copyright and are not to be used or reproduced without the written permission of MAL ENGINEERS PTY LTD (ACN 636 773 781). The contents of this drawing are electronically generated, are confidential and may only be used for the purpose for which they were intended. This is an uncontrolled document issued for information purposes only, unless the checked sections are signed and approved. Figured dimensions take precedence over scale. Do not scale from this drawing.



Drawn	NB	Date	19.12.24
Checked	ML	Date	19.12.24
Designed	TK	Date	19.12.24
Verified	ML	Date	19.12.24
Approved		Date	
M. LANCINI		XXX	

Client **RITA & NADINE SACHER**

Project **PROPOSED RENOVATIONS**
6 BELLEVUE CRESCENT, EDGE HILL

Title **ROOF FRAMING PLAN**

Status PRELIMINARY			
NOT TO BE USED FOR CONSTRUCTION PURPOSES			
Datum	AHD	Scale	AS SHOWN
Size		Size	A1
Drawing Number	Q24532-ST-04		Revision
			1